

NOTE OF CHANGES FROM DRAWING 2


- REDUCTION IN SIZE OF PLANTERS IN FRONT OF TOWN HALL TO MAINTAIN EXISTING ROADWAY WIDTH OF 29' ON BOLTWOOD AVENUE
- ADD PARALLEL PARKING SPACES ON BOTH SIDES OF BOLTWOOD AVENUE BOLTWOOD AVENUE ONE WAY (SOUTH)
- SOUTH PLEASANT STREET BUMP OUT REMOVED TO RETAIN TO RETAIN EXISTING PARKING SPACES

LEGEND

	EDGE OF WOODS		ST - STORM SEWER LINE
	DECIDUOUS TREE		S - SANITARY SEWER LINE
	CONIFEROUS TREE		W - WATER LINE
	SHRUB/BUSH		G - GAS LINE
	SIGN		SIG - SIGNAL WIRE LINE
	UTILITY POLE		C - CABLE LINE
	LIGHT POLE		FO - FIBER OPTIC LINE
	HYDRANT		LPS - LOW PRESSURE SEWER LINE
	WATER SHUTOFF		E - ELECTRIC LINE
	GAS VALVE		OHU - OVERHEAD UTILITIES
	WATER VALVE		T - TELEPHONE LINE
	MONUMENT		SMH - SANITARY MANHOLE (SMH)
	IRON PIN / IRON ROD		DMH - DRAINAGE MANHOLE (DMH)
	HANDICAP SPACE		CB - CATCHBASIN (CB)
	HAND HOLE		BOL - METAL POST/BOLLARD (BOL)
	PROPERTY LINE		MHE - ELECTRIC MANHOLE (MHE)
	EASEMENT		UMH - UNKNOWN MANHOLE
	MAJOR CONTOUR LINE		MHT - TELEPHONE MANHOLE (MHT)
	MINOR CONTOUR LINE		VP - VENT PIPE
			CNO - COULD NOT OPEN
			FD - FLOW DIRECTION

SURVEY NOTES:

- UNDERGROUND UTILITY LOCATIONS SHOWN HEREON ARE BASED ON UTILITY EVIDENCE VISIBLE AT GROUND SURFACE AND RECORD DRAWINGS AND ARE SUBJECT TO FIELD VERIFICATION BY EXCAVATION. UTILITIES SHOWN DO NOT PURPORT TO CONSTITUTE OR REPRESENT ALL UTILITIES LOCATED UPON OR ADJACENT TO THE SURVEYED PREMISES.
- SURVEY PERFORMED BY WESTON & SAMPSON PE, LS, LA, PC, IN AUGUST 2018.
- CONTOURS AND ELEVATIONS SHOWN ON NAVD83 VERTICAL DATUM BASED ON GPS OBSERVATIONS.
- NORTH ORIENTATION IS TRUE NORTH BASED ON GPS OBSERVATIONS TAKEN AT THE TIME OF THE FIELD SURVEY. MAPPING PREPARED ON NAD83 STATE PLANE COORDINATE SYSTEM-MASSACHUSETTS MAINLAND ZONE.

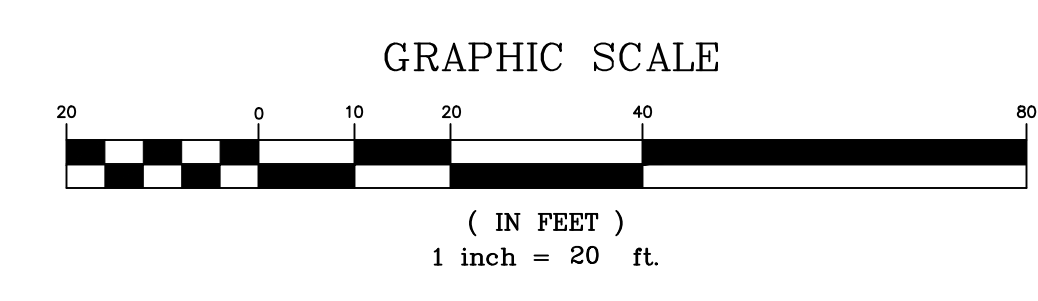

REV.	DESCRIPTION	BY	DATE

DRAWN BY: PGD
 CHECKED BY: PGD
 SCALE: 1"=20'
 DATE: FEBRUARY 1, 2021
 JOB NO.: TP20-16
 SHEET 1 OF 1

NORTH COMMON PROJECT
 NORTH COMMON
 AMHERST, MASSACHUSETTS 01002

CONCEPTUAL PLAN 2 REV.

TOWN OF AMHERST
PLANNING DEPARTMENT
4 BOLTWOOD AVENUE
AMHERST, MA 01002
413-259-3040

TOWN OF AMHERST
DEPARTMENT OF PUBLIC WORKS
ENGINEERING DIVISION
586 SOUTH PLEASANT STREET
AMHERST, MA 01002
413-259-3050

